



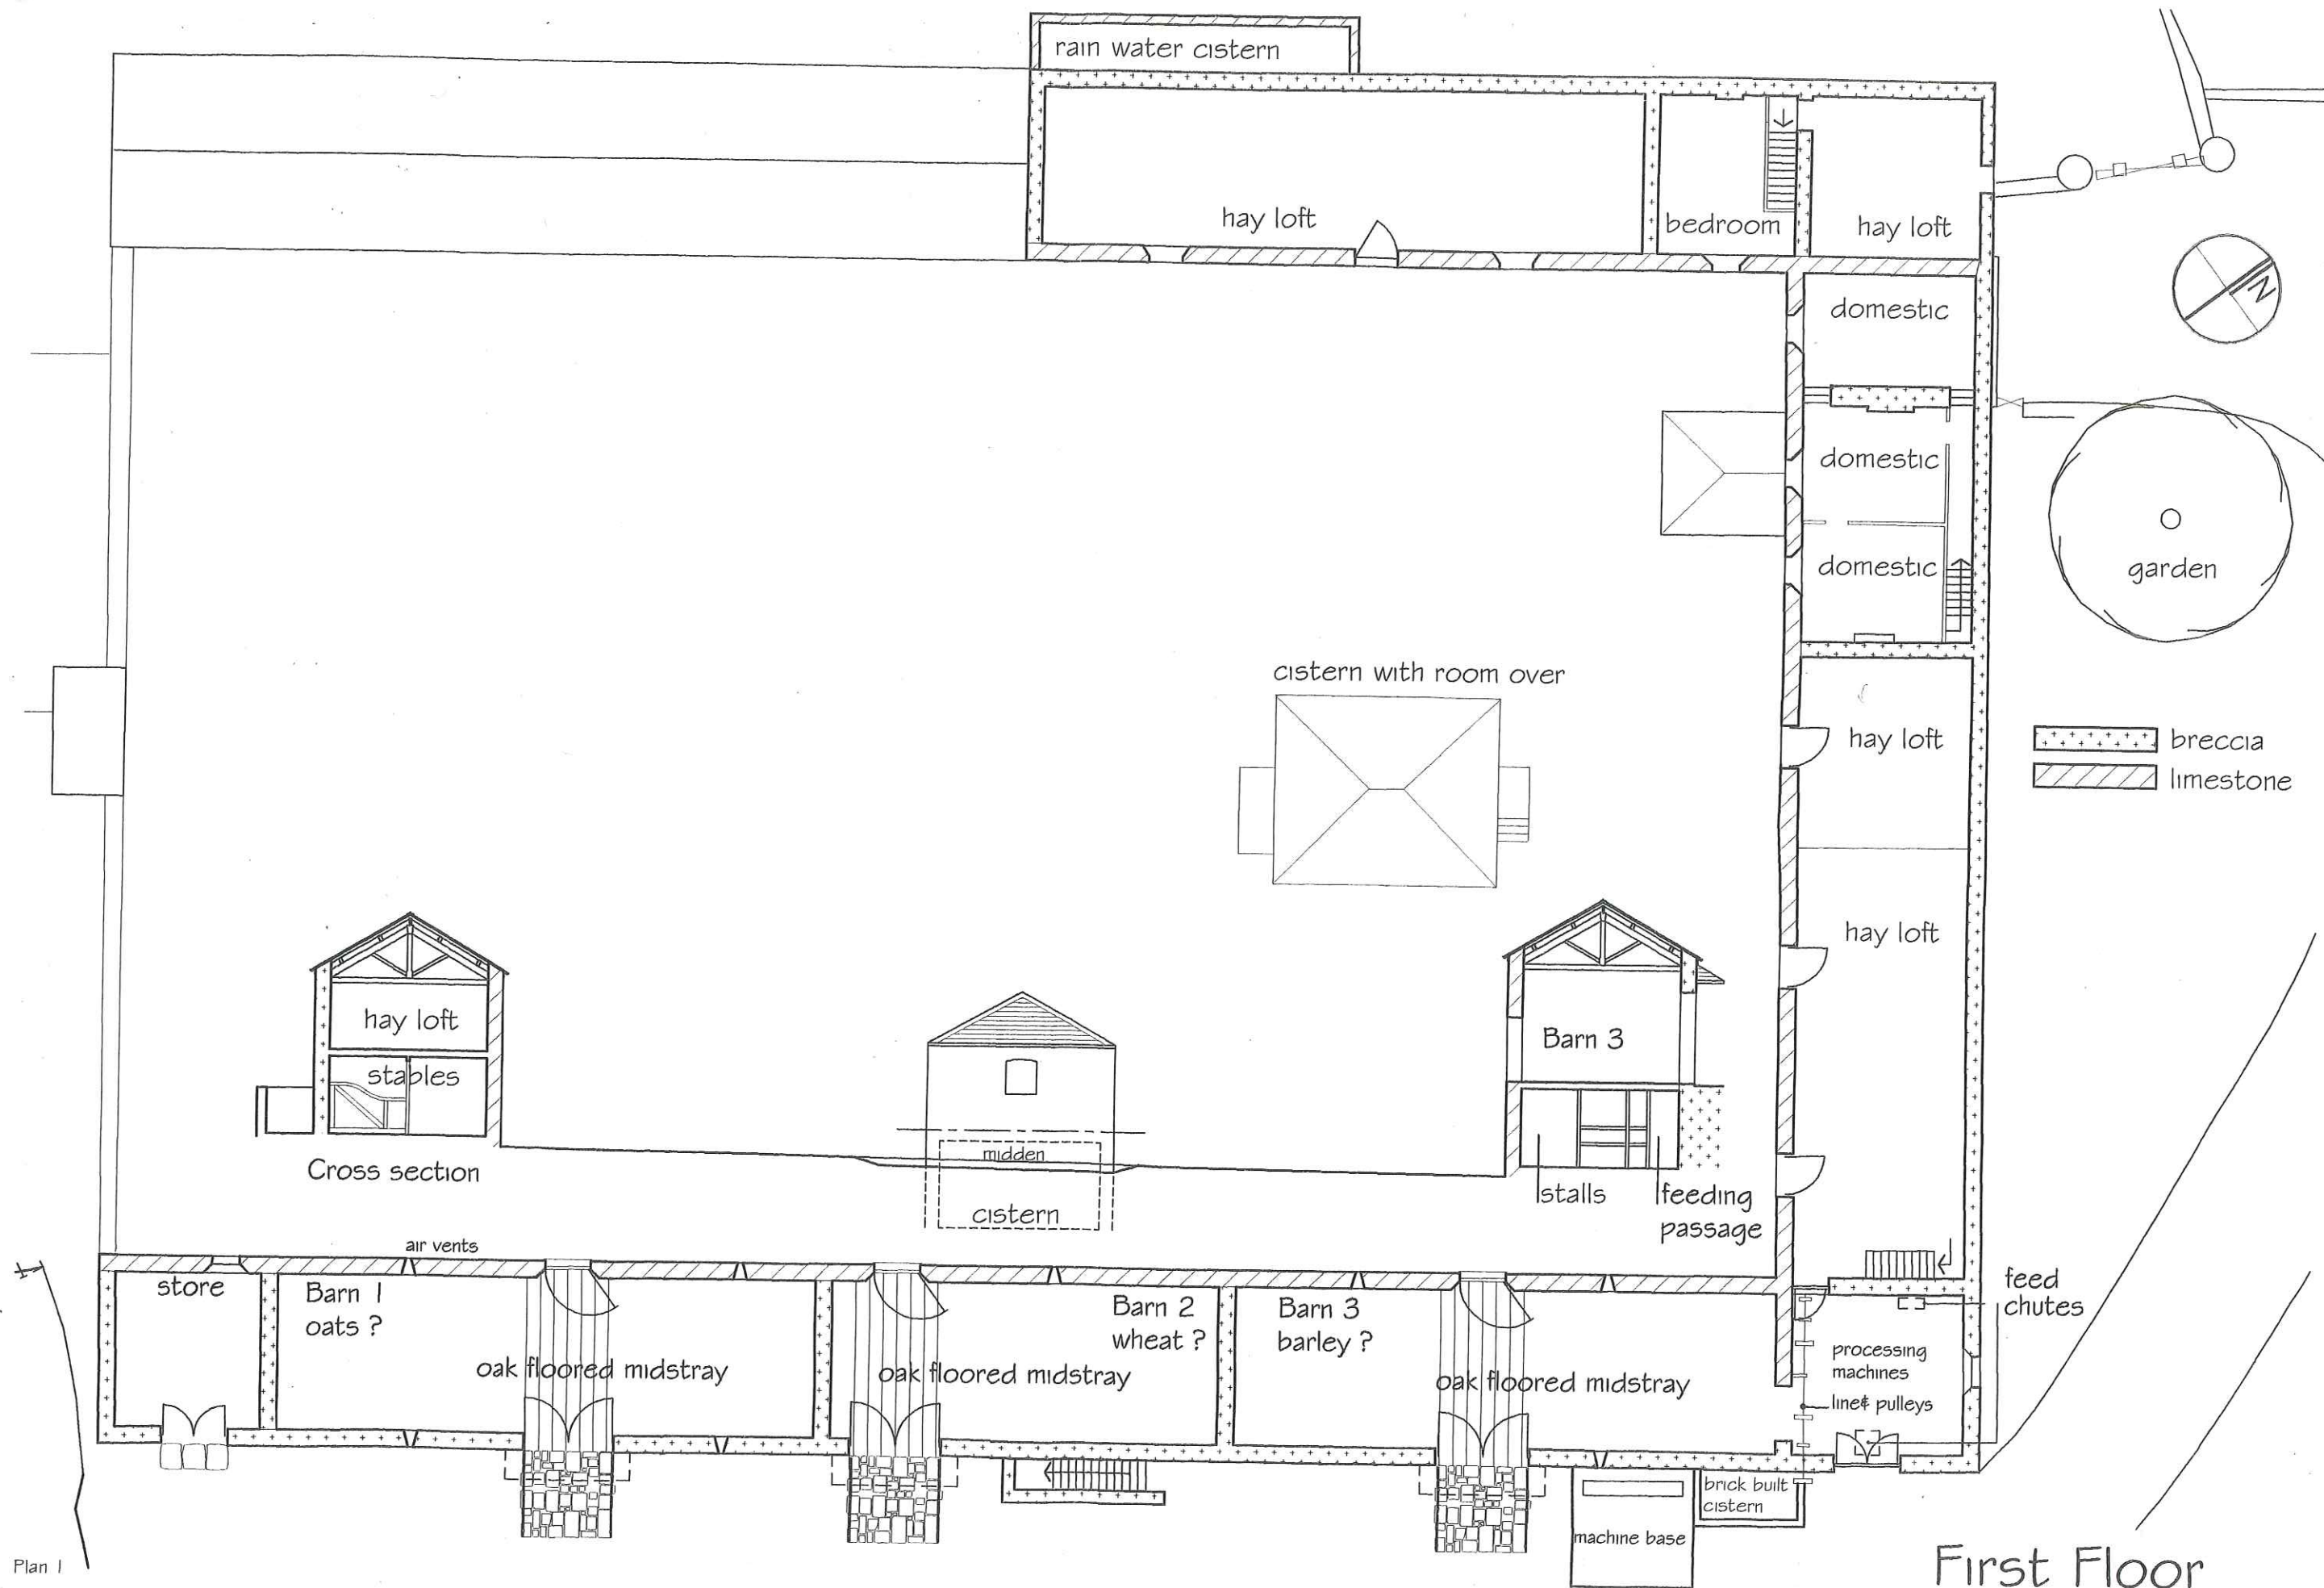

First Floor Plan
Higher Compton
Barton Marlton Devon
Map Ref: SX87 4649

As Constructed C1839
Scale: 1:200
Date: May 2000

First Floor
& Section
Plan I

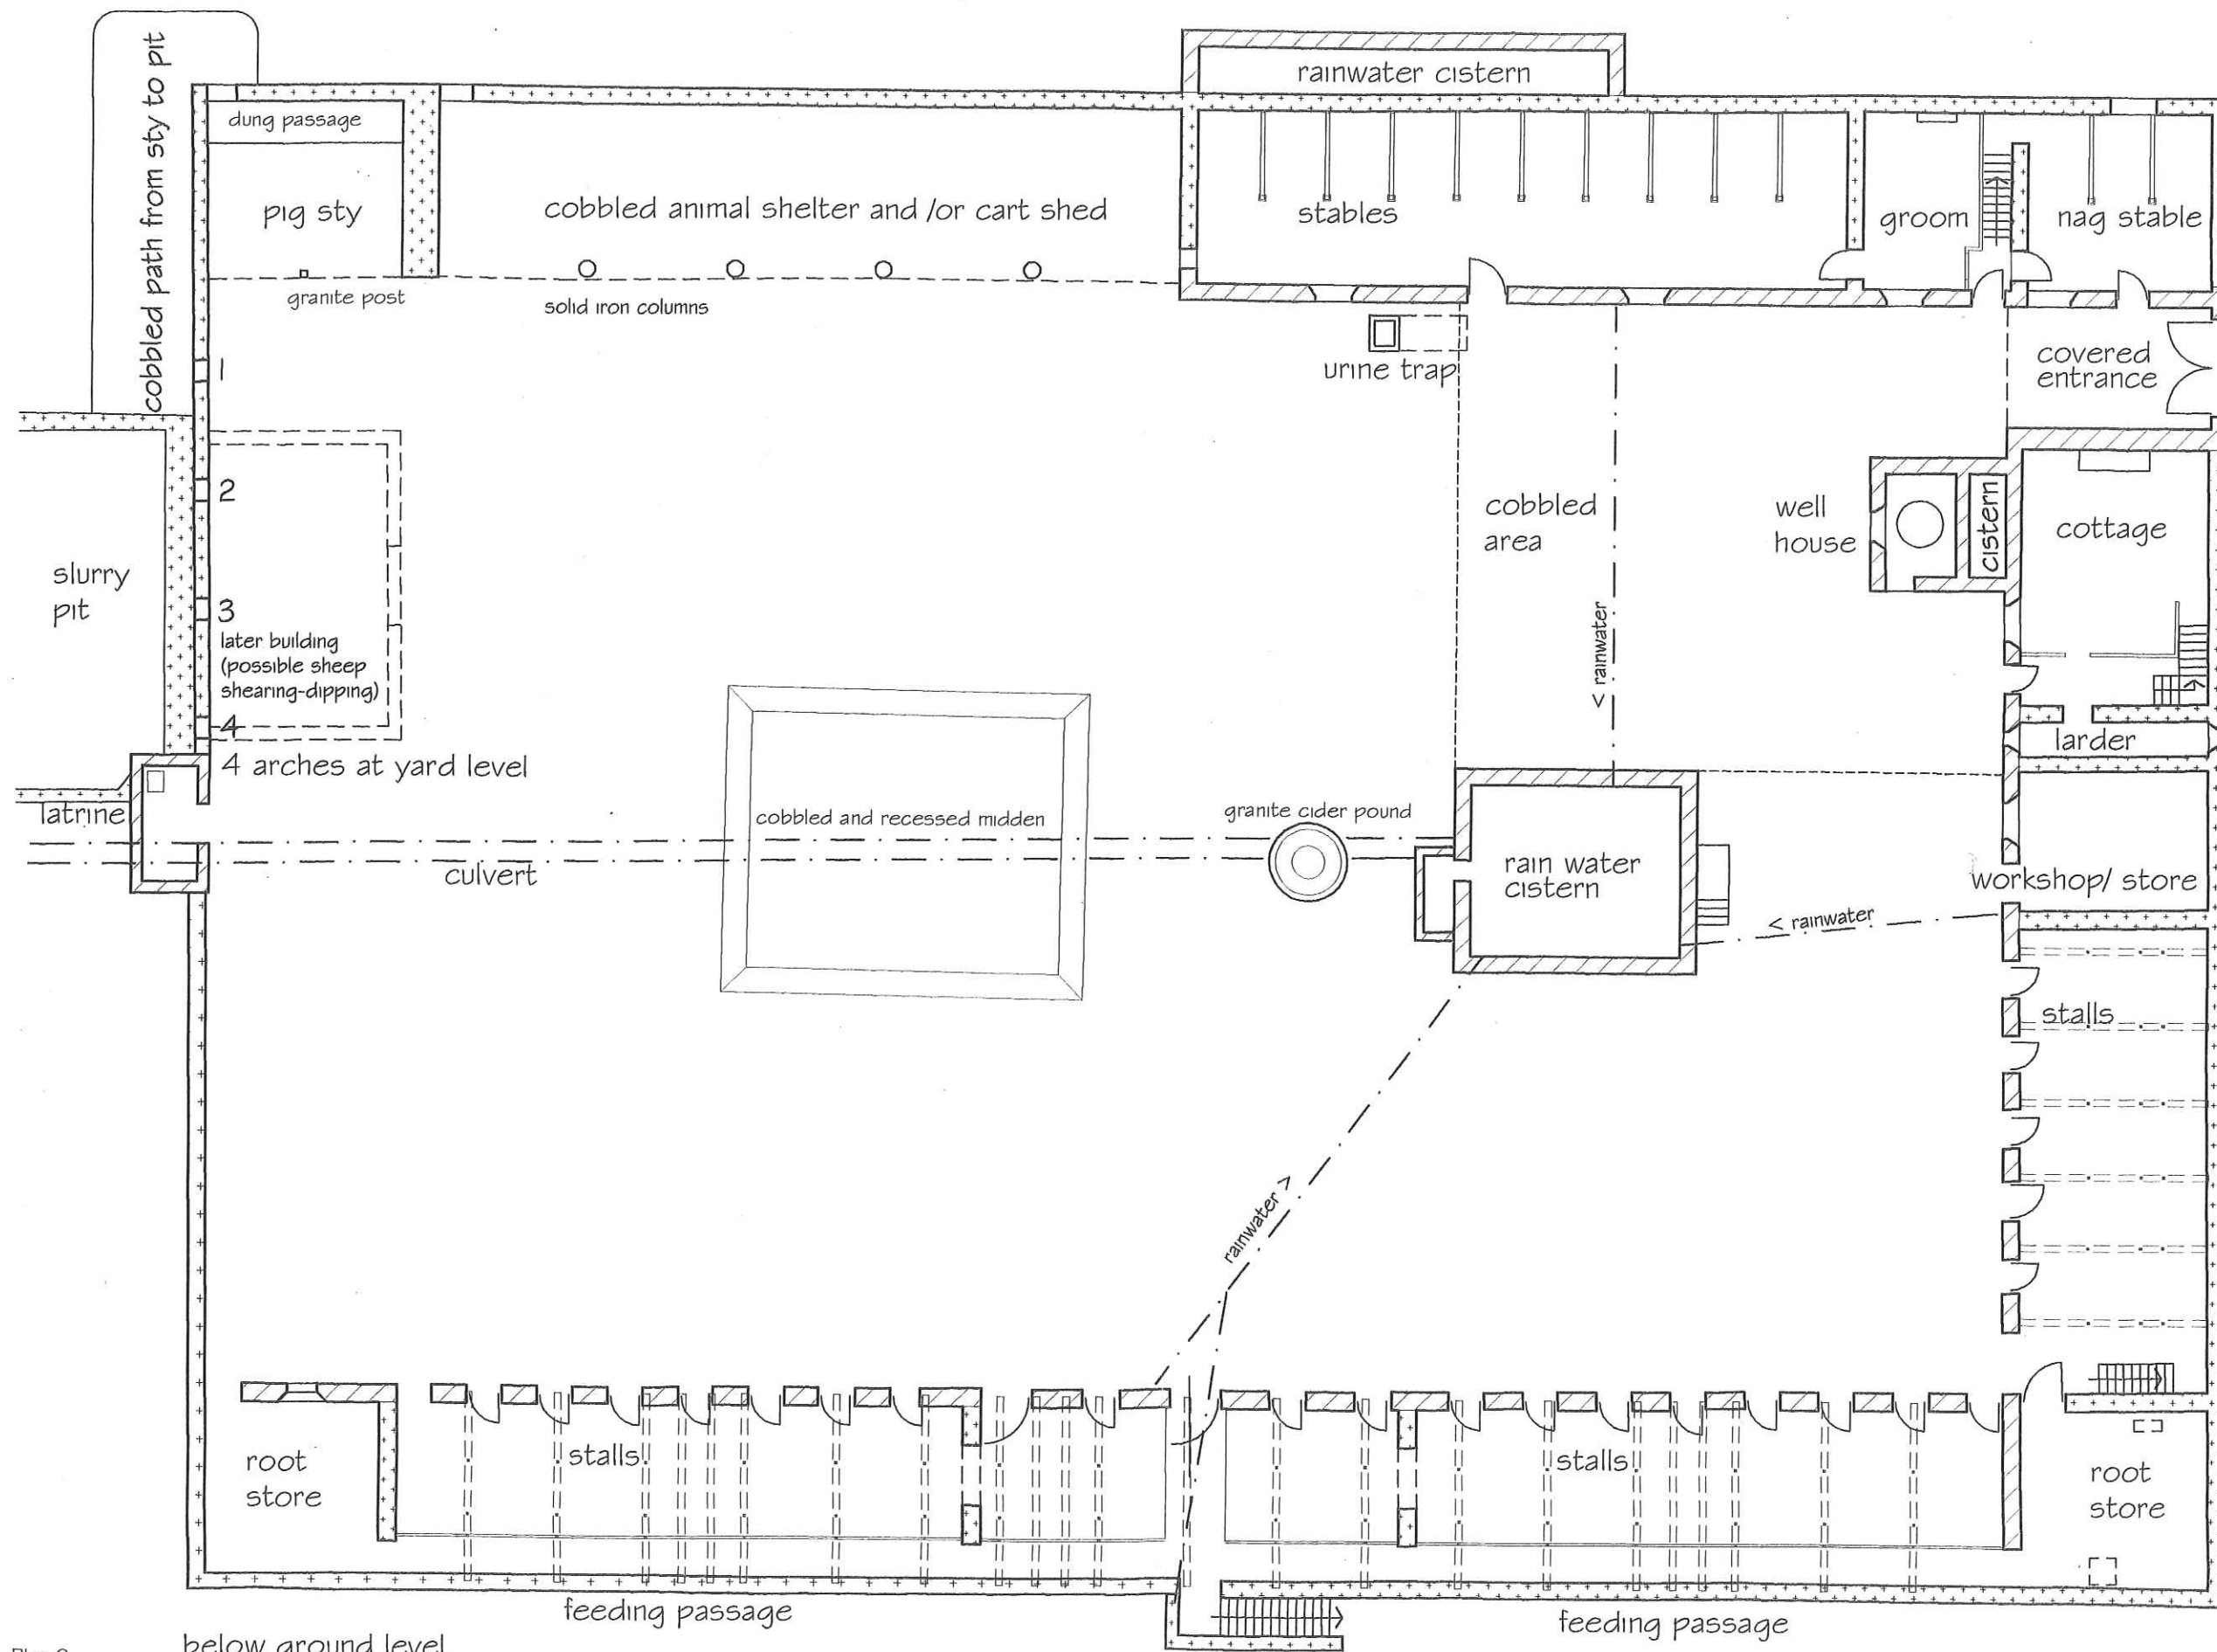


Plan 2

Ground Floor Plan
Higher Compton
Barton Marlton Devon
Map Ref: SX874649

As Constructed C1839
Scale: 1:200
Date: May 2000

breccia
limestone

Ground Floor
Plan 2

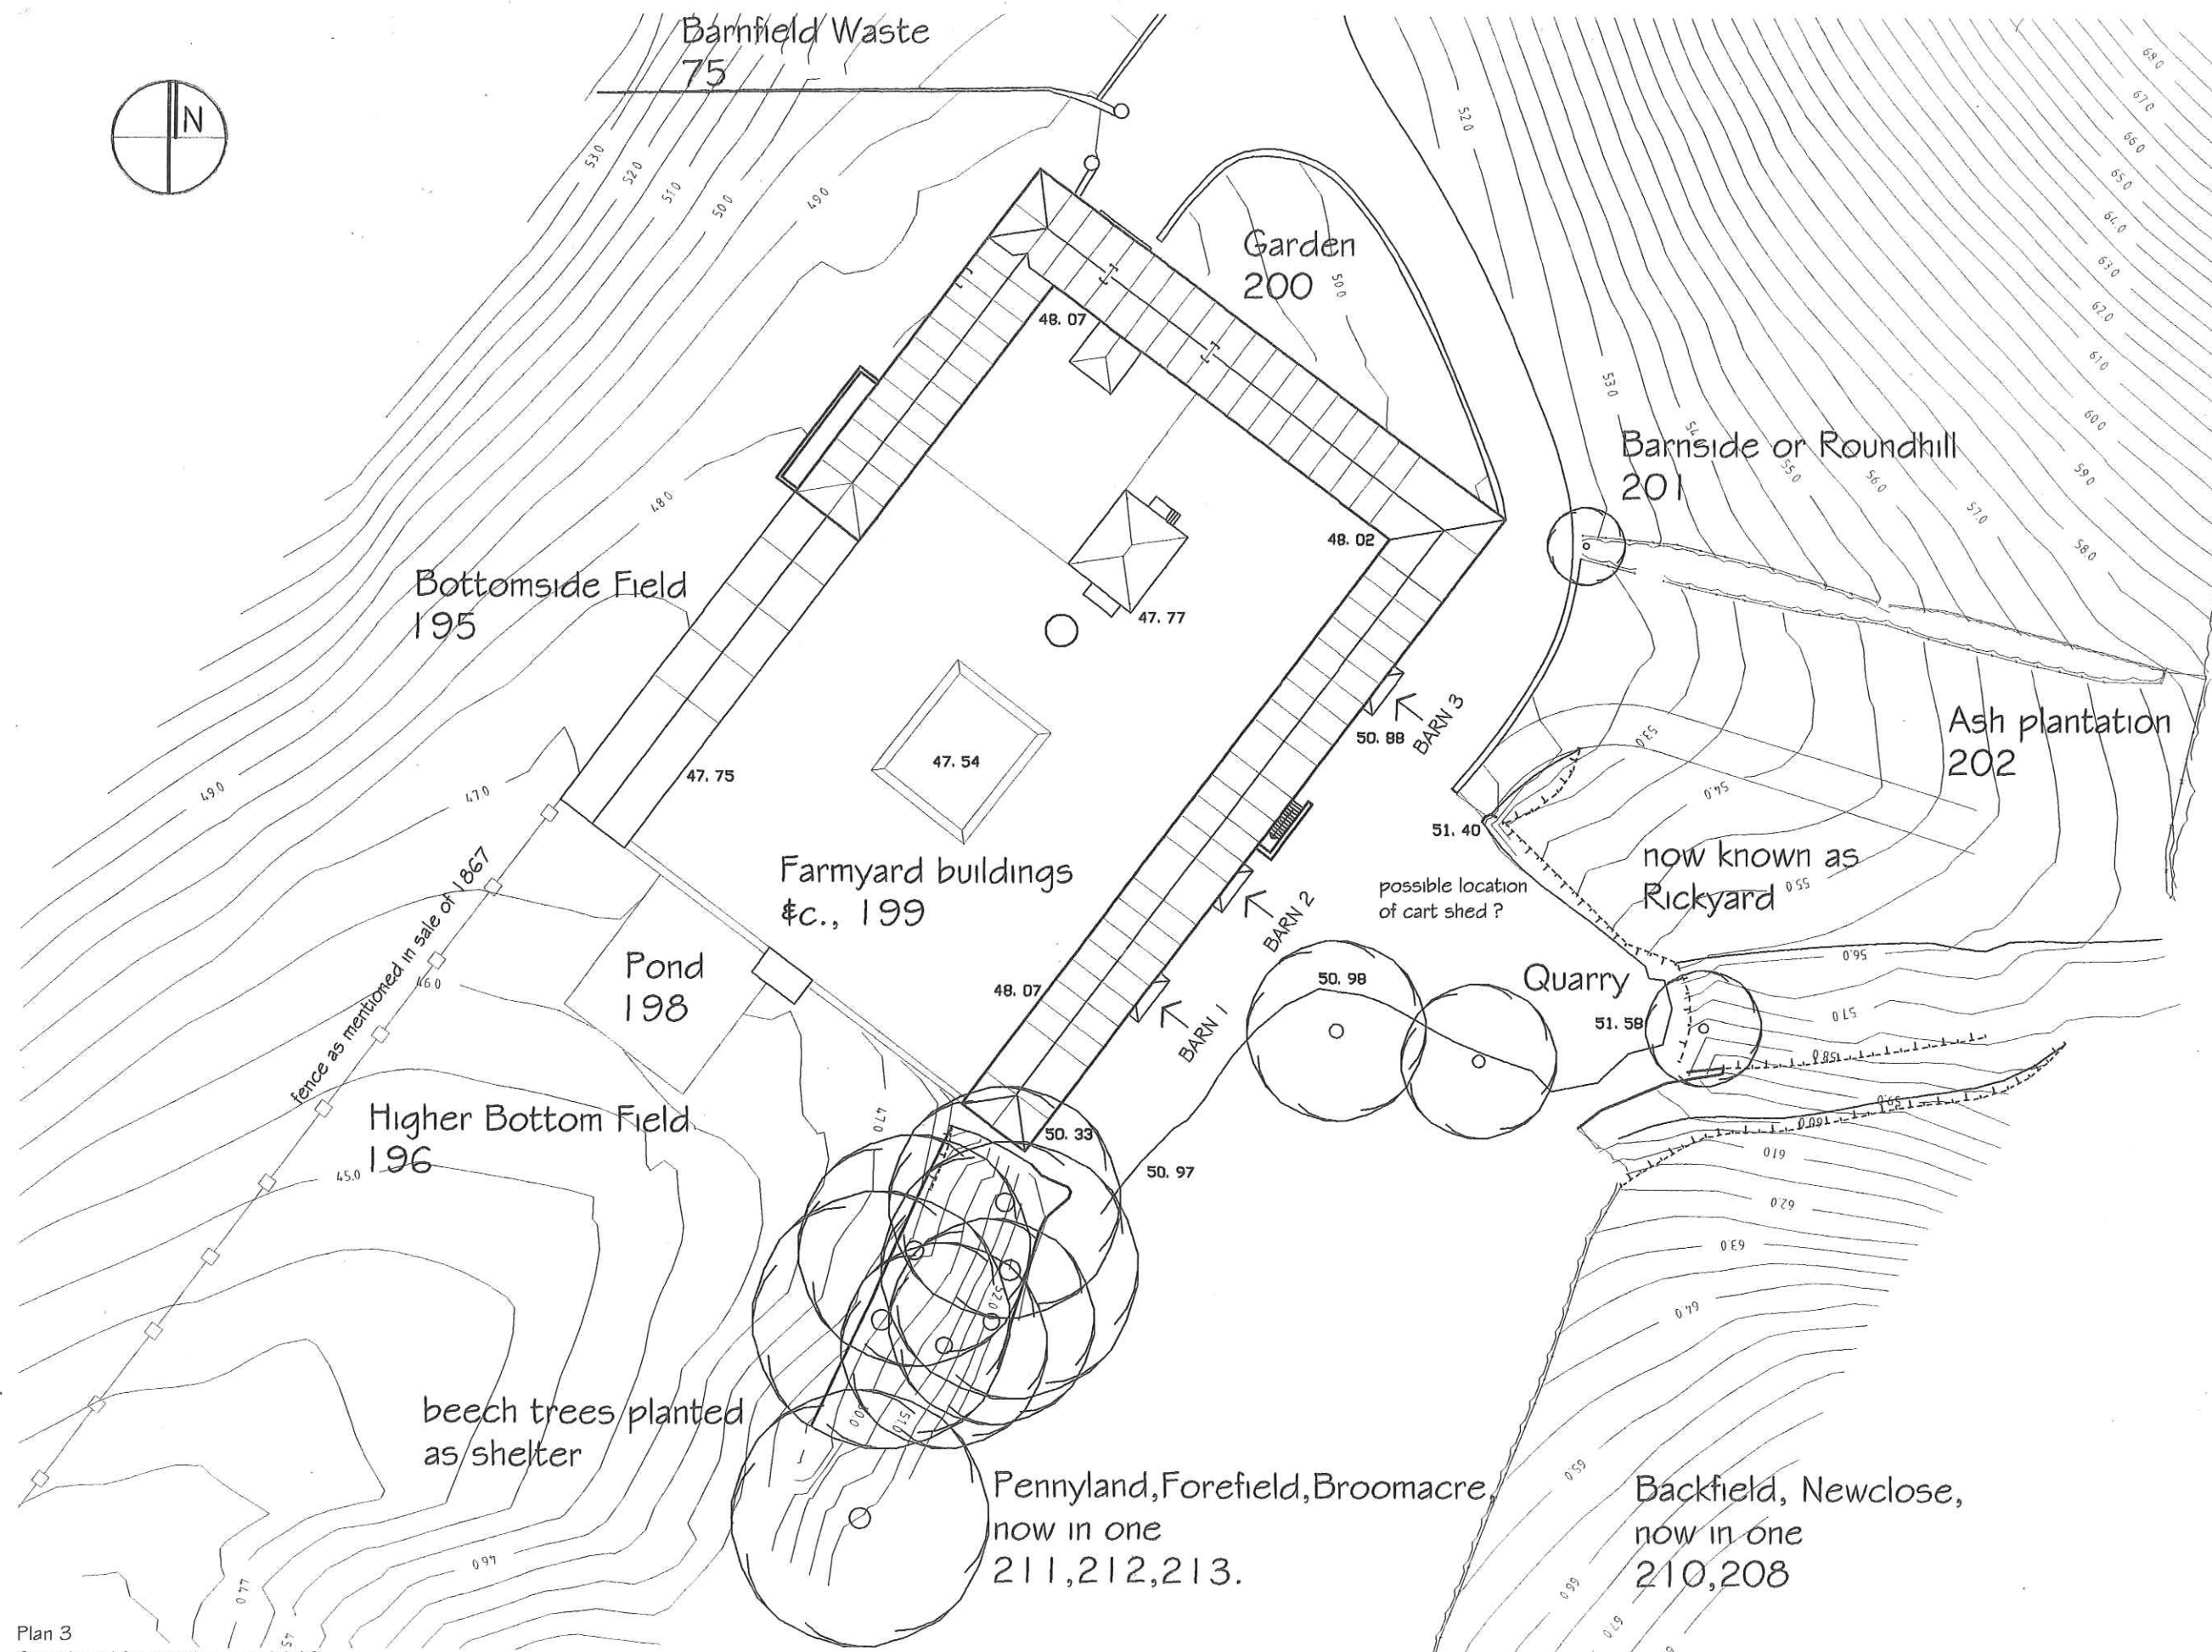

Plan 3
 Completed from Tithe map 1840
 Devon records office Exeter

Site / Roof Plan
 Higher Compton
 Barton Marldon Devon
 Map Ref: SX874649

As Constructed C1839
 Scale: 1:500
 Date: May 2000

Site Plan
 Plan 3